

KEY:

- Boundaries of Lots within Pigeon Rock supply area
- MAIN PIELINES**
- 150mm uPVC trunkmain
- 150mm uPVC trunkmain and 63mm HDPE domestic main
- 100mm uPVC trunkmain and 63mm HDPE domestic main
- 63mm HDPE domestic main
- PROPERTY SUPPLY LINES**
- 100mm uPVC irrigation and/or 25mm domestic connections

Notes:
 Telecom and control cables for the irrigation system have been installed in the same trench as the trunk mains and some of the lot connections

CAD and Production by:

CAD Solutions

Land Information House
 16 Paru Paru Road
 PO Box 913 Nelson
 Phone: 03 - 545 6888
 Fax: 03 - 548 4427
 E-mail: cadsolutions@stalgsmith.co.nz

Concept Developed by:

Land Solutions Ltd.

e-mail: landgroup@xtra.co.nz

Phone: 64-3-443 5246
 Mobile: 0274-314 089
 Fax: 64-3-4435241

PO Box 577
 Wanaka, New Zealand

Job Title:

Pigeon Rock Water Supply Company Ltd.


Drawing Title:

**"AS BUILT"
 Reticulation Stage 1**

Plan Information:

Scale @ A3= 1 : 3000

Job No.	CAD File No.	Sheet
711	711-73	1 of 2
Issue No.	Drawn	Date
issue 4	M.Graf	09/11/2009
Amendments		

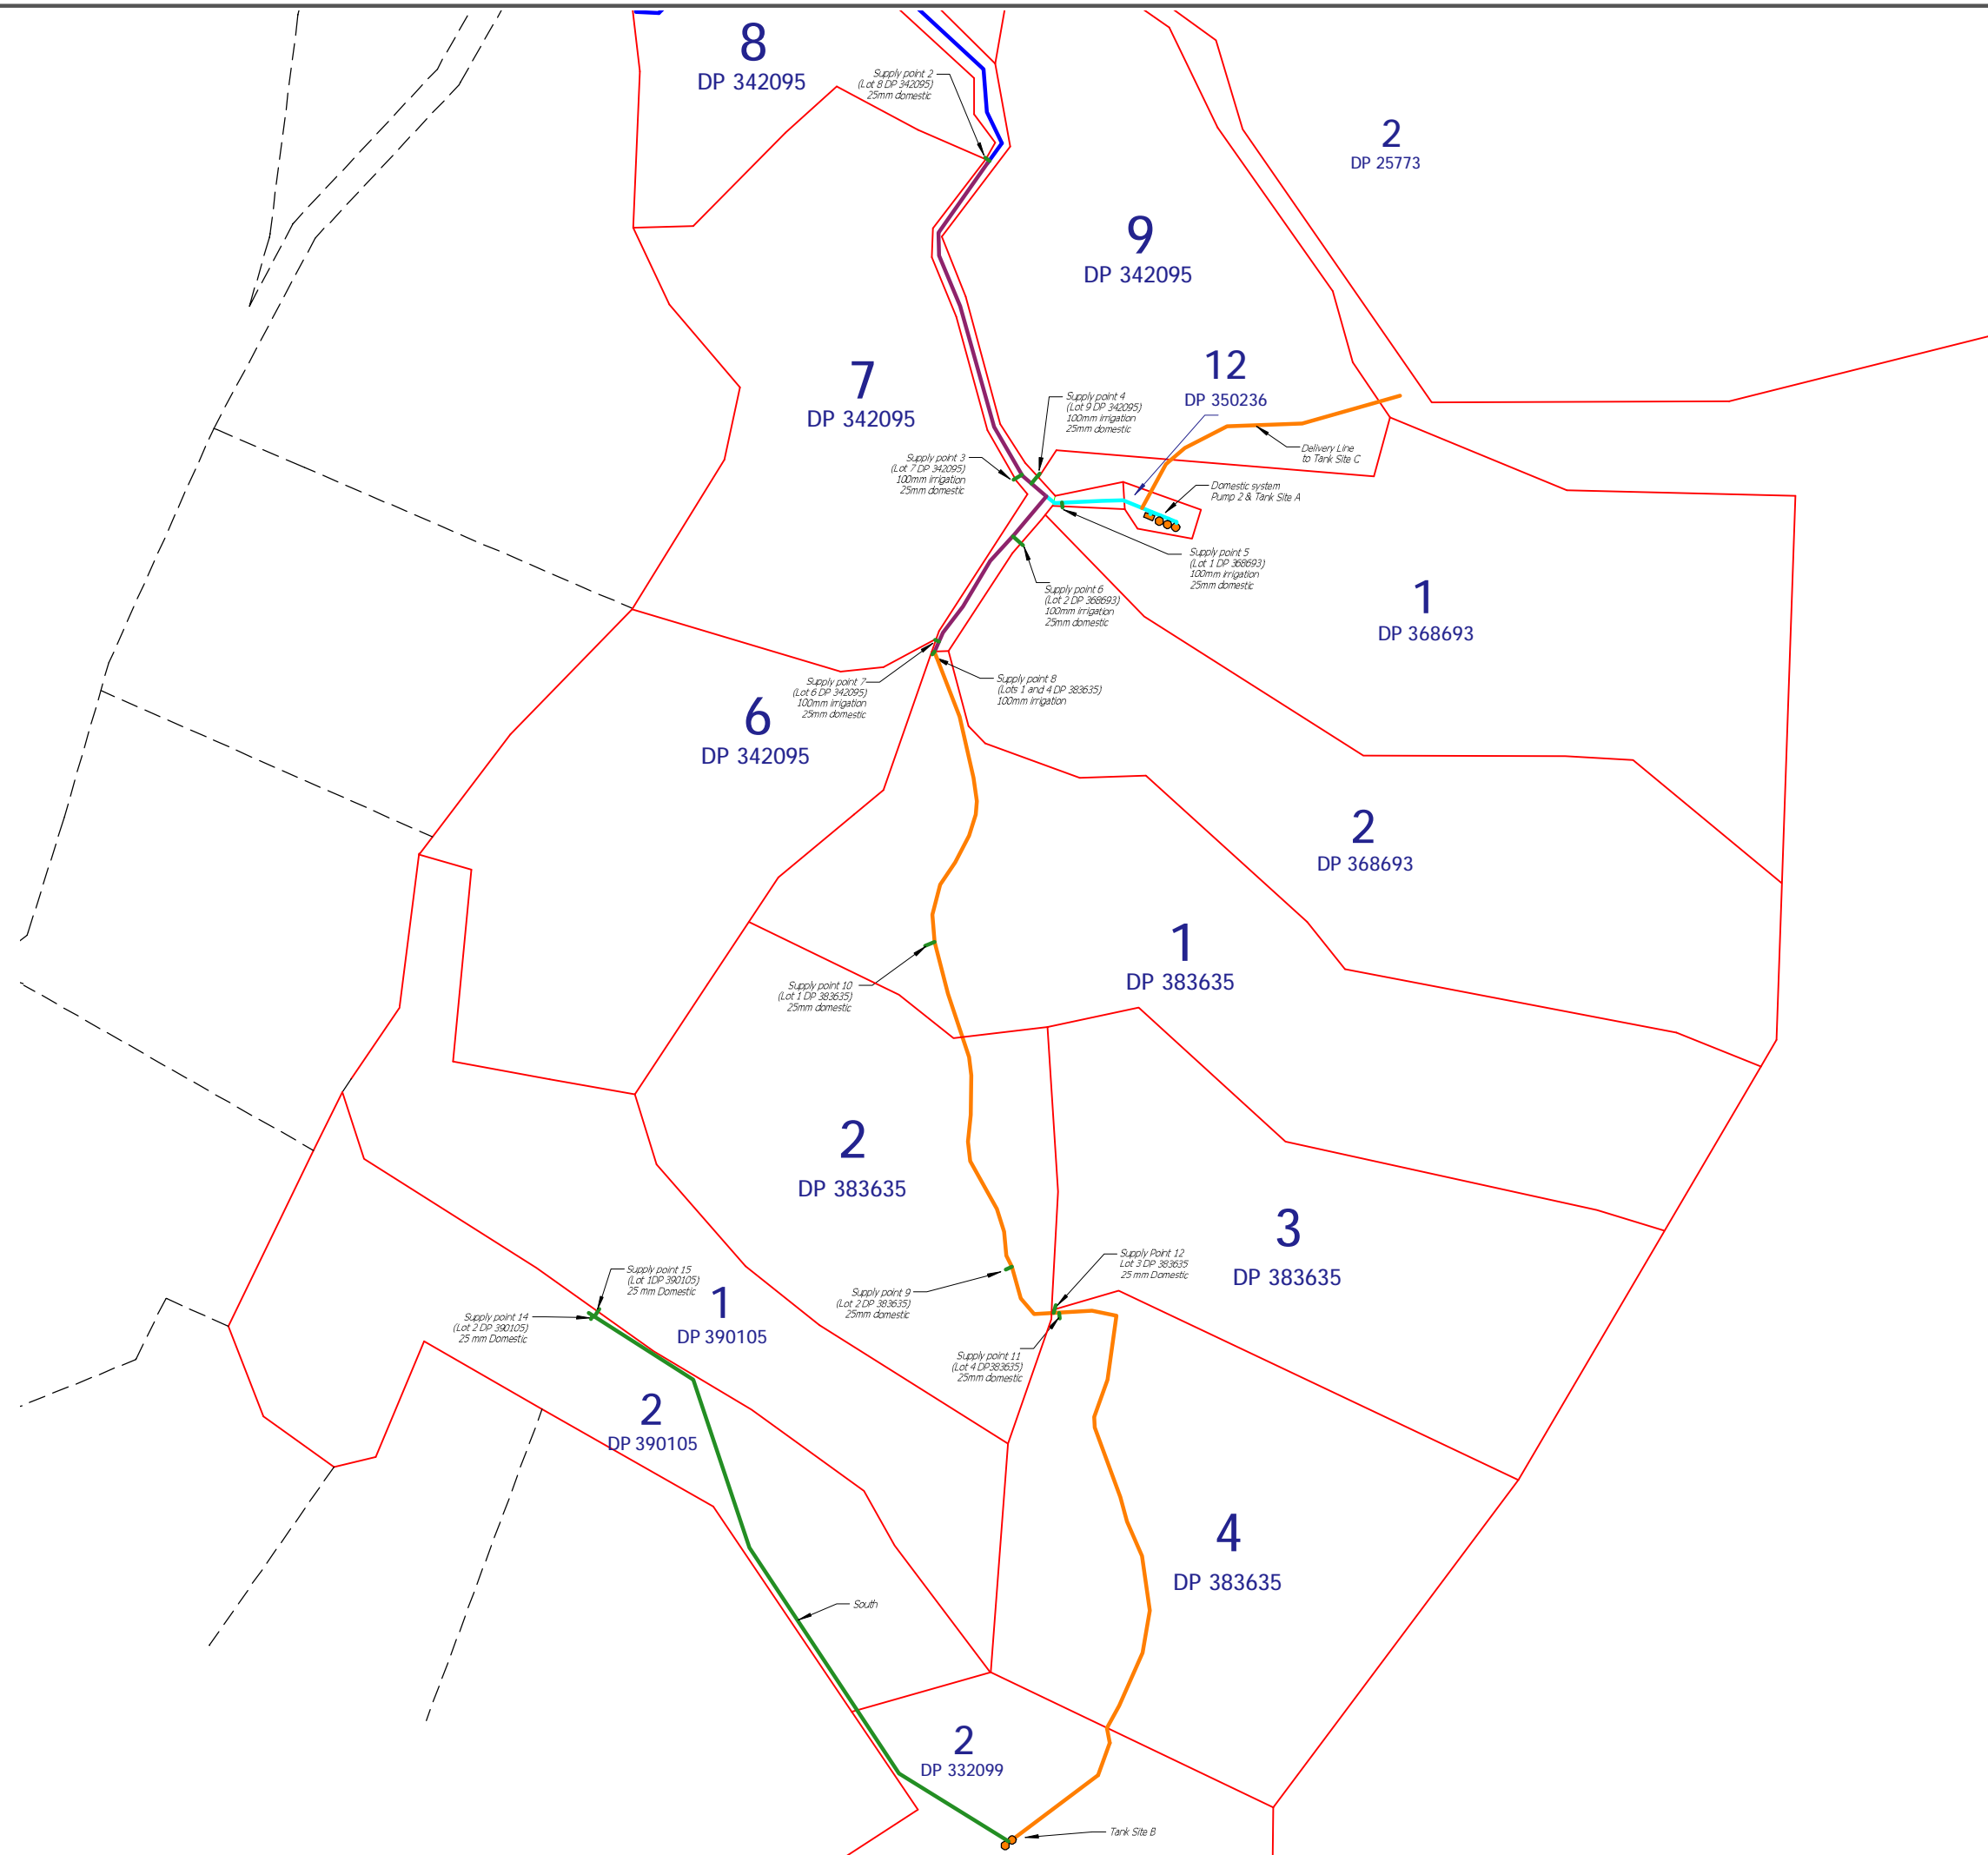

Notes:

Telecom and control cables for the irrigation system have been installed in the same trench as the trunk mains and some of the lot connections

Pigeon Rock Water Supply Co Ltd own Lot 11 DP 342095 and Lot 12 DP 350236 and hold easements over all pipelines shown on this plan.

CAD and Production by:

COMPUTER AIDED DRAUGHTING
LAND GRAPHICS
ASSET MANAGEMENT SYSTEMS

CAD Solutions

Land Information House
16 Paru Paru Road
PO Box 913 Nelson
Phone: 03 - 545 6888
Fax: 03 - 548 4427
E-mail: cadsolutions@staggsmith.co.nz

Concept Developed by:

Land Solutions Ltd.



e-mail: landgroup@xtra.co.nz

Phone: 64-3-443 5246
Mobile: 0274-314 089
Fax: 64-3-4435241

PO Box 577
Wanaka, New Zealand

Job Title:

Pigeon Rock Water Supply Company Ltd.

Drawing Title:

**"AS BUILT"
Reticulation Stage 1**

Plan Information:

Scale @ A3= 1 : 3000

Job No.	CAD File No.	Sheet
711	711-73	2 of 2
Issue No.	Drawn	Date
issue 4	M.Graf	09/11/2009

Amendments